LABOR AND MATERIALS

1	Copper ~~Lead~~	Connection 3/4	$ 1.59
1	Curb { Clock ~~Valve~~ ~~T. S. & V.~~ }	3/4 in.	$ 2.74
1	Service box ~~Old returned~~	{ Short 3½X4½ Long 4½X5½ Buff or Rdway }	$ 1.82
27	Ft. 3/4 in.	{ Copper Galv. Iron Cast Iron } Pipe at 19	$ 5.13
	Nipples	in. at	$
	Bushings	to in. at	$
	Red'g Inc'g	Couplings to in. at	$
	Union	in. at	$
	Meter	in. at	$
	Lead Joints at		$
	Compound Joints at		$
	Hrs. Foreman at		$
1	Hrs. Chauffeur at	7.5	$ 7.5
1	Hrs. Tapper at		$ 7.5
3	Hrs. Labor at	6.5	$ 19.5
	Hrs. Labor at		$
	Hrs. Compressor at		$
	Compensation Ins.		$ .09
	Trucking		$ 1.00
	Builders Use of Water	3	$ 5.00
	Tap by Maguire		$
			$
			$
			$
			$ 20.87

42/45

St. 140
~~Pl.~~
~~Ave.~~ No. 126

Hunter

Name of Owner

Ball

Labor and Mat'l. Report Nov 28 1945

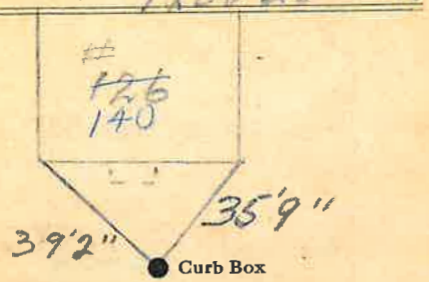

6 Main

Elev. of Main at tap 4

Gate at ●

● Gate at

TAX ID # 303.13-6-10

● Curb Box

LSM-5C-6-1-45