LABOR AND MATERIALS

1	Copper / Lead — Connection	3/4	$ 1.59
1	Curb — Clock / Valve / T. S. & V.	3/4 in.	$ 2.74
1	Service box — Old returned — Short 3½X4½ / Long 4½X5½ / Buff or Rdway		$ 1.82
27 Ft.	3/4 in. — Copper / Galv. Iron / Cast Iron	Pipe at 19	$ 5.13
	Nipples — in. at		$
	Bushings — to — in. at		$
	Red'g / Inc'g — Couplings — to — in. at		$
	Union — in. at		$
	Meter — in. at		$
	Lead Joints at		$
	Compound Joints at		$
	Hrs. Foreman at		$
2	Hrs. Chauffeur at	75	$ 1.50
1	Hrs. Tapper at	75	$ .75
2	Hrs. Labor at	65	$ 1.30
	Hrs. Labor at		$
	Hrs. Compressor at		$
	Compensation Ins.		$ .09
	Trucking		$ 1.00
	Builders Use of Water	½	$ 5.00
1 lb.	Magnum		$
			$
			$
			$
			$ 20.92

43,45

St. ~~Pl.~~ 142

Hunter ~~Ave.~~ No. 128

Name of Owner

Ball

Labor and Mat'l. Report Nov 28 1945

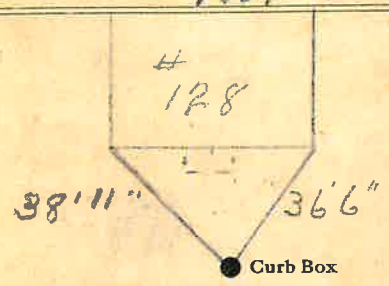

6 Main — Elev. of Main at tap 4

Gate at ● — ● Gate at

● Curb Box

LSM-5C-6-1-45