LABOR AND MATERIALS

1	Copper ~~Lead~~ Connection 3/4	$ 1.59
1	Curb {Clock Valve ~~T. S. & V.~~} 3/4 in.	$ 2.74
1	Service box Old returned {Short 3½X4½ Long 4½X5½ Buff or Rdway}	$ 1.82
27	Ft. 3/4 in. {Copper Galv. Iron Cast Iron} Pipe at 19	$ 5.13
	Nipples in. at	$
	Bushings to in. at	$
	Red'g Inc'g Couplings to in. at	$
	Union in. at	$
	Meter in. at	$
	Lead Joints at	$
	Compound Joints at	$
	Hrs. Foreman at 7.5	$ 7.50
1	Hrs. Chauffeur at 7.5	$ 1.50
2	Hrs. Tapper at 6.5	$ 1.30
	Hrs. Labor at	$
	Hrs. Labor at	$
	Hrs. Compressor at	$ .09
	Compensation Ins.	$ 1.00
	Trucking	$ 5.00
	Builders Use of Water ?	$
	Tap by Magnuson	$
		$
		$
		$
		$ 20.92

44-45

St. 144
~~Pl.~~
~~Ave.~~ No. 130

Hunter

Name of Owner

Ball

Labor and Mat'l. Report Nov 28 1945

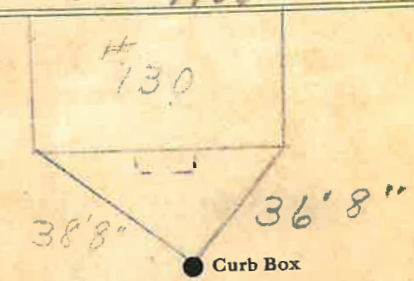

6 Main

Elev. of Main at tap 4½

Gate at

Gate at

TAX ID #303.13-6-12

Curb Box

LSM-5C-6-1-45