LABOR AND MATERIALS

1	Copper / Lead } Connection 3/4		$ 1.79
1	Curb { Clock / Valve / T. S. & V. } 3/4 in.		$ 2.61
1	Service box / Old returned { Short 3½X4½ / Long 4½X5½ / Buff or Rdway }		$ 1.82
9	Ft. 3/4 in. { Copper / Galv. Iron / Cast Iron } Pipe at 23		$ 2.07
	Nipples in. at		$
	Bushings to in. at		$
	Red'g / Inc'g } Couplings to in. at		$
	Union in. at		$
	Meter in. at		$
	Lead Joints at		$
	Compound Joints at		$
	Hrs. Foreman at		$
	Hrs. Chauffeur at		$
1½	Hrs. Tapper at 82½		$ 124
	Hrs. Labor at		$
2	Hrs. Labor at 71½		$ 143
	Hrs. Compressor at		$
	Compensation Ins.		$ .07
	Trucking		$ 1 —
	Builders Use of Water not finished		$ —
	Tap by Maguinn		$
			$
			$
	This Curb Box Masure from		$
	146		$ 17.03

103 - 46

Hunter St. ~~Pl.~~ ~~Ave.~~ No. 145

Name of Owner

Ball

Labor and Mat'l. Report Nov 8 1946

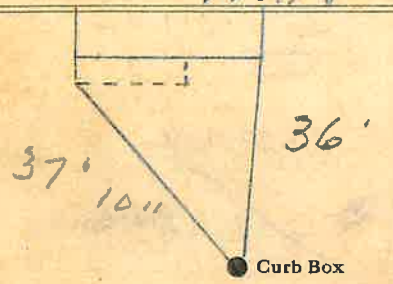

6 Main Elev. of Main at tap 4

Gate at ● ● Gate at

● Curb Box

37' 10" 36'

LSM-5C-6-1-45