LABOR AND MATERIALS

1	~~Copper Lead~~ Connection	3/4	$ 1.79
1	Curb { Clock Valve T. S. & V. }	3/4 in.	$ 2.61
1	Service box Old returned { ~~Short 3½X4½~~ Long 4¼X5½ ~~Buff or Rdway~~ }		$ 1.82
19 ~~10~~	Ft. 3/4 in. { Copper Galv. Iron Cast Iron }	Pipe at 23	$ 3.45
	Nipples in. at		$
	Bushings to in. at		$
	Red'g Inc'g Couplings to in. at		$
	Union in. at		$
	Meter in. at		$
	Lead Joints at		$
	Compound Joints at		$
	Hrs. Foreman at		$
5	Hrs. Chauffeur at	82½	$ 4.13
8	Hrs. Tapper at		$
8	Hrs. Labor at	71½	$ 5.72
	Hrs. Labor at		$
	Hrs. Compressor at		$
	Compensation Ins.		$ .27
	Trucking		$ 1.00
	Builders Use of Water		$
	Tap by Wasinski		$
			$
			$
			$
			$ 20.79

✓

T0-746

Ida — St. ~~Pl.~~ ~~Ave.~~ No. 1

Name of Owner

C Elms (Garage)

Labor and Mat'l. Report Aug 5 1946

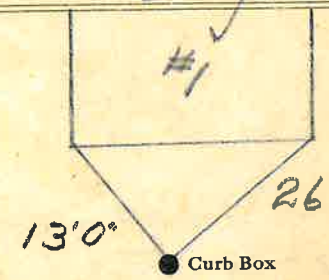

6" C.I. - 1974

2" Main

Elev. of Main at tap 5'

Gate at ● ● Gate at

NEW CURB STOP & COPPER INSTALLED AUG. 6, 2000

● Curb Box

Changed over FROM old 2" MAIN - to New 6" MAIN - April - 1974

LSM-5C-6-1-45