Labor and Materials

1	Copper / ~~Lead~~	Connection	3/4	$ 1.46
1	Curb	~~Cock~~ / ~~Valve~~ / F. S. & V.	in 3/4	$ 1.93
1	Service Box Old returned	~~Short 3½ x 4½~~ / Long 4½ x 5½ / Buff. or Rdway		$ 1.77
12 Ft.	in.	Copper / ~~Galv Iron~~ / ~~Cast Iron~~ Pipe at	3/4	$ 2.64
	Nipples	in. at		$
	Bushings	to in. at		$
	Red'g / Inc'g Couplings	to in. at		$
	Union	in. at		$
	Meter	in. at		$
	Lead Joints at			$
	Leadite Joints at			$
	Hrs. Foreman at			$
3	Hrs, Chauffeur at	62½		$ 1.88
4	Hrs. Tapper at	62½		$ 2.50
	Hrs. Labor at			$
	Hrs. Labor at			$
	Hrs. Compressor at			$
	Compensation Ins.			$ .15
	Trucking			$ 1.00
	Builders Use of Water	Patch (Sewer)		$ 2.50
				$
				$
				$
Tap made by Penn				$
				$ 15.83

9 1 – 1937

~~St.~~ / ~~Pl.~~ Jackson Ave. No. 13

Name of Owner

Malone

Labor and Mat'l. Report Aug 19 37

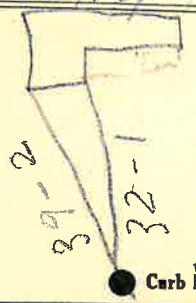

6 Main

Elev. of Main at tap 4½

Gate at • • Gate at

• Curb Box

New House

#1