LABOR AND MATERIALS

1 Copper / ~~Lead~~ } Connection 3/4" ..... $.....

1 Curb } Cock / Valve / T. S. & V. } 3/4 in. ..... $.....

1 Service box } ~~Old returned~~ { ~~Short 3½ x 4½~~ / Long 4½ x 5½ / Buff or Rdway } ..... $.....

26 Ft. 3/4 in. { Copper / ~~G. I.~~ / ~~C. I.~~ } Pipe at ..... $.....

..... Nipples ..... in. at ..... $.....

..... Bushings ..... to ..... in. at ..... $.....

..... Red'g / Inc'g } Coupl'gs ..... to ..... in. at ..... $.....

..... Union ..... in. at ..... $.....

..... Meter ..... in. at ..... $.....

..... Lead Joints at ..... $.....

..... Compound Joints at ..... $.....

..... Maintenance Foreman ..... $.....

..... Hrs. Water Maint. Man—1 at ..... $.....

..... Hrs. Water Maint. Man—2 at ..... $.....

..... Hrs. Garage Foreman ..... at ..... $.....

..... Hrs. Labor— ..... at ..... $.....

..... Hrs. Compressor at ..... $.....

..... Compensation Ins. at $..... per C ..... $.....

..... Trucking ..... $.....

..... Pav't Patch ..... $.....

Tap by Gibsford & Co. 7-17-56 ..... $.....

..... $.....

..... $.....

..... O'head ..... $.....

$.....

V

James ~~St.~~ ~~Pl.~~ Ct. Ave. No. 7

Name of Owner Dunn & Stevenson

Labor and Mat'l. Report July 17 1956

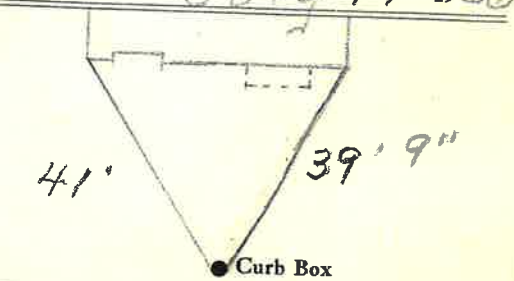

6" Main Elev. of Main at tap 5'-1"

Gate at ● ● Gate at

26' to MAIN

● Curb Box

LSM—5C—2-5 56