Labor and Materials

1	Lead Connection 3/4	$
1	Curb Cock 3/4	$
1	Service Box / Old returned { Short 3½ x 4½ / ~~Long 4½ x~~ 5½ / ~~Buffalo~~	$
9	Ft. 3/4 in. G. I. Pipe at	$
	Nipples in. at	$
	Bushings to in. at	$
	Red'g Coup to in. at	$
	Inc'g Coup to in. at	$
	Union in. at	$
	Meter in. at	$
	Cu. Yds. Br. Stone at	$
	Cu. Yds. Sand at	$
	Bags Cement at	$
	Paving Brick { Mack / Red / Asphalt } at	$
	Hrs. Foreman at	$
9	Hrs. Common Labor at	$
	Hrs. Mason at	$
3	Hrs. Pen or at	$
	Hrs. at	$
	Builders' Use of Water	$
	at	$
	Truck at	$
	at	$
	at	$
	Total	$

19 July 14 19 20

Labor and Material Report

8 Jay St.

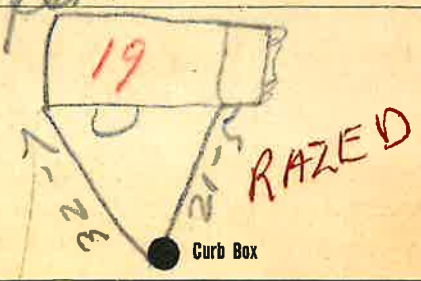

Shut off Curb

4 Main 10-27-54 Elev. of Main at tap 4½

Gate at ● ● Gate at

● Curb Box

Linehan

This Place Razed. To be dug up at main.