LABOR AND MATERIALS

1 Copper / ~~Lead~~ Connection 3/4	$	2.71
1 Curb { ~~Cock~~ / ~~Valve~~ / ~~T. S. & V.~~ } 3/4 in.	$	3.83
1 Service box { ~~Short 3½ x 4½~~ / ~~Long 4½ x 5½~~ / ~~Buff or Rdway~~ } Old returned	$	4.69
17 Ft. 3/4 in. { ~~Copper~~ / ~~C. I.~~ / ~~C. I.~~ } Pipe at 45	$	7.65
____ Nipples ____ in. at ____	$	
____ Bushings ____ to ____ in. at ____	$	
____ Red'g / Inc'g Coupl'gs ____ to ____ in. at ____	$	
____ Union ____ in. at ____	$	
____ Meter ____ in. at ____	$	
____ Lead Joints at ____	$	
____ Compound Joints at ____	$	
____ Maintenance Foreman ____	$	18.96
____ Hrs. Water Maint. Man—1 at ____	$	
8 Hrs. Water Maint. Man—2 at 1.24	$	9.92
____ Hrs. Garage Foreman ____ at ____	$	
8 Hrs. Labor— ____ at 1.13	$	9.04
____ Hrs. Compressor at ____	$	
____ Compensation Ins. at $ 4.29 per C	$	.81
____ Trucking ____	$	1.50
____ Pay't Patch ____	$	12.15
Tap by Giraird 9-8-55	$	
	$	
	$	
____ O'head ____	$	
	$	52.30

Jay St. / ~~Pl.~~ Ave. No. 24

Name of Owner

Giraird

Labor and Mat'l. Report Sept. 8 19 55

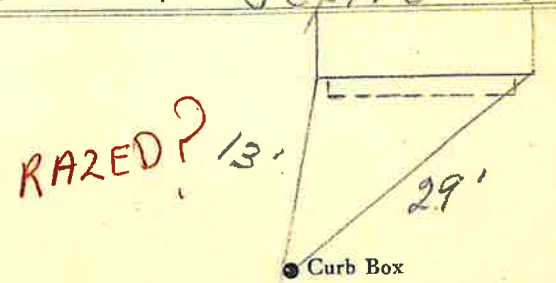

4" Main

Elev. of Main at tap 5 1/2'

Gate at ●

● Gate at

● Curb Box

L M—5C—2-1-54