## LABOR AND MATERIALS

| | | | |
|---|---|---|---|
| 1 | Copper / ~~Lead~~ Connection | 3/4 | $ 1.23 |
| 1 | Curb Cock / ~~Valve~~ / ~~T. S. & V.~~ | 3/4 in. | $ 1.68 |
| 1 | Service Box Old returned Short 3½x4½ / Long 4½x5½ / Buff. or Rdway | | $ 1.75 |
| 23 | Ft. 3/4 in. Copper / ~~Galv Iron~~ / ~~Cast Iron~~ Pipe at 15 | | $ 3.45 |
| | Nipples in. at | | $ |
| | Bushings to in. at | | $ |
| | Red'g / Inc'g Couplings to in. at | | $ |
| | Union in. at | | $ |
| | Meter in. at | | $ |
| | Lead Joints at | | $ |
| | Leadite Joints at | | $ |
| | Hrs. Foreman at | | $ |
| 3 | Hrs. Chauffeur at | 62½ | $ 1.88 |
| 3 | Hrs. Tapper at | " | $ 1.87 |
| 6 | Hrs. Labor at | 45 | $ 2.70 |
| | Hrs. Labor at | | $ |
| | Hrs. Compressor at | | $ |
| | Compensation Ins. | | $ 20 |
| | Trucking | | $ 1.— |
| | Builders Use of Water no patch (BP) | | $ |
| | Tuply Hessell | | $ |
| | | | $ |
| | | | $ |
| | | | $ |
| | | | $ 15.76 |

1 5 3 - 1938

St. 7
~~Pl.~~
Jefferson Ave. No. 3

Name of Owner
Moulton

Labor and Mat'l. Report Nov 12 1938

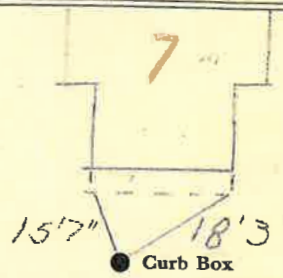


6 Main

Elev. of Main at tap 5

Gate at ●

● Gate at

● Curb Box

old Tap Shut off

Tax ID #302.16-11-32