Labor and Materials

1 Copper / Lead } Connection 3/4 ..... $.....

1 ..... Curb { Cock / Valve / T. S. & V. } 3/4 ... in. ..... $.....

1 ..... Service Box { Old returned } { Short 3½ x 4½ / Long 4½ x 5½ / Buff. or Rdway } ..... $.....

8 ..... Ft. 3/4 ... in. { Copper / Galv. Iron / Cast Iron } Pipe at ..... $.....

..... Nipples ..... in. at ..... $.....

..... Bushings ..... to ..... in. at ..... $.....

Red'g / Inc'g } Couplings ..... to ..... in. at ..... $.....

..... Union ..... in. at ..... $.....

..... Meter ..... in. at ..... $.....

..... Lbs. Br. Stone at ..... $.....

..... Lbs. Sand at ..... $.....

..... Bags Cement at ..... $.....

..... Paving Brick { Mack / Red / Asphalt } at ..... $.....

..... Lead Joints at ..... $.....

..... Leadite Joints at ..... $.....

2 ... Hrs. Foreman at ..... $.....

4 ... Hrs. Common Labor at ..... $.....

..... Hrs. Common Labor at ..... $.....

..... Hrs. Mason at ..... $.....

..... Hrs Mason's Helper at ..... $.....

..... Hrs. Compressor at ..... $.....

..... Compensation Ins. ..... $.....

..... Trucking ..... $.....

Gl Builders' Use of Water ..... $.....

Total $.....

14

Labor and Material Report Nov. 2-1 1925

No 6 Jefferson St.

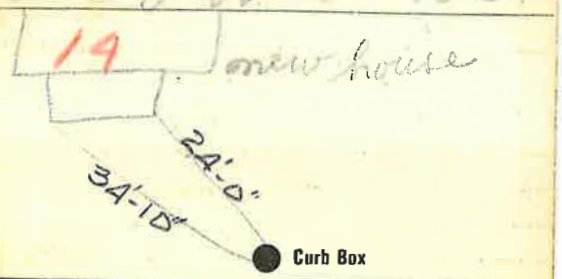

6" Main

Elev. of Main at tap 5'-1"

Gate at ● ● Gate at

● Curb Box

Tax TD # 302.16-10-11