LABOR AND MATERIALS

1	Copper ~~Lead~~ Connection 3/4	$ 1.23
1	Curb { ~~Cock~~ ~~Valve~~ ~~T. S. & V.~~ } 3/4 in.	$ 1.68
1	Service Box Old returned { ~~Short 3½x4½~~ ~~Long 4½x5½~~ ~~Buff. or Rdway~~ }	$ 1.75
23	Ft. 3/4 in. { Copper ~~Galv Iron~~ ~~Cast Iron~~ } Pipe at	$ 3.45
	Nipples ____ in. at	$
	Bushings ____ to ____ in. at	$
	Red'g Inc'g Couplings ____ to ____ in. at	$
	Union ____ in. at	$
	Meter ____ in. at	$
	Lead Joints at	$
	Leadite Joints at	$
	Hrs. Foreman at	$
3	Hrs. Chauffeur at 62½	$ 1.88
3	Hrs. Tapper at	$ 1.87
6	Hrs. Labor at 45	$ 2.70
	Hrs. Labor at	$
	Hrs. Compressor at	$
	Compensation Ins.	$ .20
	Trucking	$ 1.—
	Builders Use of Water hospital (BH)	$
	Tap by Hessell	$
		$
		$
		$ 15.76

1 5 6 - 1938

St.
~~Pl.~~
Jefferson Ave. No. 11

Name of Owner

Catherine Gray

Labor and Mat'l. Report Nov 14 1938

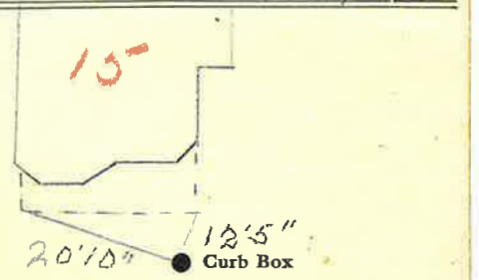

6" Main

Elev. of Main at tap 5"

Gate at ●

● Gate at

● Curb Box

All old shut off

TAX ID# 302.16-11-28