LABOR AND MATERIALS

1	Copper ~~Lead~~ } Connection 3/4	$ 1.78
1	Curb { Clock ~~Valve~~ ~~T. S. & V.~~ } 3/4 in.	$ 2.61
1	Service box Old returned { ~~Short 3½X4½~~ Long 4½X5½ ~~Buff or Rdway~~ }	$ 1.82
28	Ft. 3/4 in. { Copper ~~Galv. Iron~~ ~~Cast Iron~~ } Pipe at 23	$ 6.44
	Nipples in. at	$
	Bushings to in. at	$
	Red'g Inc'g } Couplings to in. at	$
	Union in. at	$
	Meter in. at	$
	Lead Joints at	$
	Compound Joints at	$
	Hrs. Foreman at	$
	Hrs. Chauffeur at	$
8	Hrs. Tapper at 75	$ 600
6	Hrs. Labor at 65	$ 390 9.90
	Hrs. Labor at	$
	Hrs. Compressor at	$
	Compensation Ins.	$ 27
	Trucking	$ 1.00
	Builders Use of Water ?	$ 5.00
	Tap by Mcqueen	$
		$
		$
		$
		$ 28.82

14 ✓ 46

John

St. ~~Pl.~~ ~~Ave.~~ No. ~~3~~ 7

Name of Owner

Marzolo

Labor and Mat'l. Report Apr 23 1946

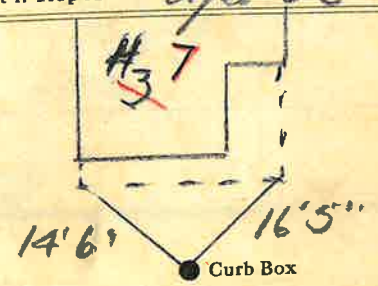

6 Main

Elev. of Main at tap 5

Gate at ●

● Gate at

● Curb Box

LSM-5C-6-1-45