LABOR AND MATERIALS

1	Copper Lead } Connection	3/4	$ 1.35
1	Curb { Cock Valve T. S. & V. }	3/4 in.	$ 1.80
1	Service Box Old returned { Short 3⅛x4½ Long 4½x5½ Buff or Rdway }		$ 1.70
27 Ft.	3/4 in. { Copper Galv Iron Cast Iron } Pipe at	18	$ 4.86
	Nipples in. at		$
	Bushings to in. at		$
	Red'g Inc'g } Couplings to in. at		$
	Union in. at		$
	Meter in. at		$
	Lead Joints at		$
	Leadite Joints at		$
	Hrs. Foreman at		$
6	Hrs. Chauffeur at	62½	$ 3.75
8	Hrs. Tapper at		$ 5.—
9	Hrs. Labor at	.45	$ 4.05
	Hrs. Labor at		$
1	Hrs. Compressor at	62½	$ .63
	Compensation Ins.		$ .39
	Trucking		$ 1.—
	Builders Use of Water	Patch	$ 5.00
	Tap by Hesse		$
			$
			$
			$
			$ 29.53

1 6 1941

St. 9
Pl.
Ave. No. 5

John

Name of Owner

Merwin

Labor and Mat'l. Report Sept 27 19 41

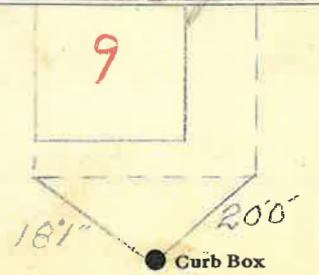

6 Main

Elev. of Main at tap 6

Gate at ●

● Gate at

TAX ID # 302.16-7-3

● Curb Box