Labor and Materials

1	Copper Lead	Connection 3/4"	$ 1.46
1	Curb	Cock / ~~Valve~~ / ~~T. S. & V.~~ 3/4" in	$ 1.93
1	Service Box Old returned	Short ~~3½ x 4½~~ / Long 4½ x 5½ / ~~Buff. or Rdway~~	$ 1.77
19	Ft. 3/4 in.	Copper / ~~Galv Iron~~ / ~~Cast Iron~~ Pipe at 2Y	$ 4.18
	Nipples	in. at	$
	Bushings	to in. at	$
	Red'g Inc'g Couplings	to in. at	$
	Union	in. at	$
	Meter	in. at	$
	Lead Joints at		$
	Leadite Joints at		$
2	Hrs. Foreman at 32½		$ .63
4	Hrs. Chauffeur at 62½		$ 2.50
	Hrs. Tapper at		$
1.3	Hrs. Labor at 45		$ 5.85
	Hrs. Labor at		$
	Hrs. Compressor at		$
	Compensation Ins.		$ .28
	Trucking		$ 1.00
	Builders Use of Water Patch		$ 5.00
			$
			$
			$
	Tap made by Penn		$
			$ 24.60

1 8-1937

St. / ~~Pl.~~ / ~~Ave.~~ Janet No. 4

Name of Owner

Bennett

Labor and Mat'l. Report May 4 19 37

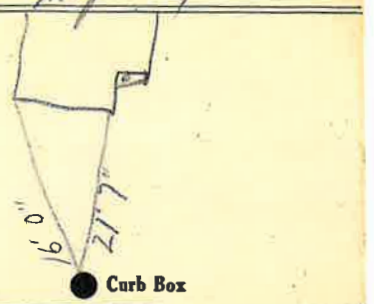

4" Main — Elev. of Main at tap 4½

Gate at • — • Gate at

• Curb Box

Old tap shut off

MB