Labor and Materials

1	Lead Connection 3/4	$
1	Curb Cock 1 1/4	$
1	Service Box Old returned { Short 3½ x 4½ / Long 4½ x 5½ / Buffalo	$
7	Ft. ~~1"~~ ~~in. G. I. Pipe~~ 3/4 copper at	$
	Nipples in. at	$
1	Bushings 1/2 to 1" in. at	$
	Red'g Coup to in. at	$
	Inc'g Coup to in. at	$
	Union in. at	$
	Meter in. at	$
	Cu. Yds. Br. Stone at	$
	Cu. Yds. Sand at	$
	Bags Cement at	$
	Paving Brick { Mack / Red / Asphalt } at	$
1	Hrs. Foreman at Prior	$
1	Hrs. Common Labor at	$
	Hrs. Mason at	$
	Hrs. at	$
	Hrs. at	$
9.0	Builders' Use of Water	$
	at	$
	Truck 100 at	$
	at	$
	at	$
	Total	$ 7.54

Labor and Material Report Aug 19

3/4 Tap No 5 Jun 1 1/4

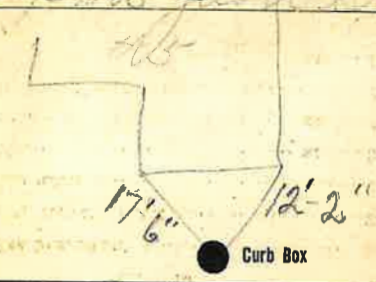

4 Main

Elev. of Main at tap 4 1/2

Gate at ● ● Gate at

TAX ID # 309.12-9-14

● Curb Box

Renewal Tap May 2, '91