Labor and Materials

Copper / Lead } Connection ..... $.....

Curb { Cock / Valve / T. S. & V. } ..... in ..... $.....

Service Box / Old returned { Short 3½ x 4½ / Long 4½ x 5½ / Buff. or Rdway } ..... $.....

.....Ft. .....in. { Copper / Galv Iron / Cast Iron } Pipe at ..... $.....

..... Nipples .....in. at ..... $.....

.....Bushings .....to .....in. at..... $.....

Red'g / Inc'g } Couplings.....to.....in. at ..... $.....

.....Union..... .....in. at ..... $.....

.....Meter.....in. at ..... $.....

.....Lead Joints at ..... $.....

.....Leadite Joints at ..... $.....

.....Hrs. Foreman at ..... $.....

.....Hrs. Chauffeur at ..... $.....

.....Hrs. Tapper at ..... $.....

.....Hrs. Labor at ..... $.....

.....Hrs. Labor at ..... $.....

.....Hrs. Compressor at ..... $.....

.....Compensation Ins. ..... $.....

.....Trucking ..... $.....

.....Builders Use of Water ..... $.....

..... $.....

..... $.....

..... $.....

..... $.....

$.....


Name of Owner

Labor and Mat'l. Report 19

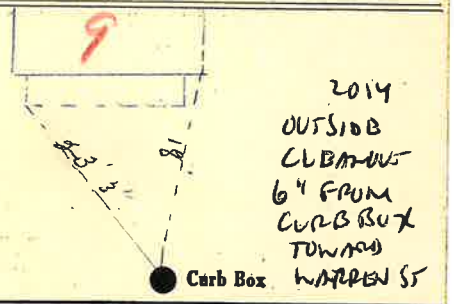

2014 OUTSIDE CLEANOUT 6' FROM CURB BOX TOWARD WARREN ST

.....Main

Elev. of Main at tap..... .....

Gate at •

• Gate at

• Curb Box