LABOR AND MATERIALS

1	Copper Lead } Connection	3/4"	$ 1.35
1	Curb { Cock Valve T. S. & V. }	3/4" in.	$ 1.80
1	Service Box Old returned { Short 3⅛x4⅛ Long 4⅛x5⅛ Buff or Rdway }		$ 1.70
24 Ft. 3/4 in.	{ Copper Galv Iron Cast Iron } Pipe at	18	$ 4.32
	Nipples ... in. at		$
	Bushings ... to ... in. at		$
	Red'g Inc'g } Couplings ... to ... in. at		$
	Union ... in. at		$
	Meter ... in. at		$
	Lead Joints at		$
	Leadite Joints at		$
	Hrs. Foreman at		$
	Hrs. Chauffeur at		$
	Hrs. Tapper at		$
	Hrs. Labor at		$
	Hrs. Labor at		$
	Hrs. Compressor at		$
	Compensation Ins.		$
	Trucking		$ 1.—
	Builders Use of Water Dufore Paving		$
			$
			$
Tap by Hassel			$
			$

49 1941

St.
~~Pl.~~
~~Ave.~~ No. 3

Keenan

Name of Owner

Mrs William Ford

Labor and Mat'l. Report April 21 1941

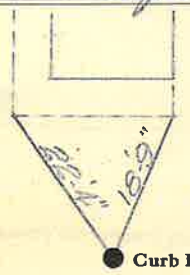

6" Main

Elev. of Main at tap 5'

Gate at ● ● Gate at

● Curb Box

To be Billed