LABOR AND MATERIALS

1	Copper ~~Lead~~ Connection 3/4	$ 1.23
1	Curb { Cock ~~Valve~~ ~~T. S. & V.~~ } 3/4 in.	$ 1.68
1	Service Box Old returned { Short 3½x4½ Long 4½x5½ Buff. or Rdway }	$ 175
26	Ft. 3/4 in. { Copper Galv Iron Cast Iron } Pipe at	$ 4.10
	Nipples ____ in. at	$
	Bushings ____ to ____ in. at	$
	Red'g Inc'g } Couplings ____ to ____ in. at	$
	Union ____ in. at	$
	Meter ____ in. at	$
	Lead Joints at	$
	Leadite Joints at	$
	Hrs. Foreman at	$
3	Hrs. Chauffeur at 62½	$ 1.88
8	Hrs. Tapper at "	$ 5.00
10	Hrs. Labor at 45	$ 4.50
	Hrs. Labor at	$
	Hrs. Compressor at	$
	Compensation Ins.	$ .35
	Trucking	$ 1.00
	Builders Use of Water —	$ 5.00
	Tap by Hassell	$
		$
		$
		$
		$ 21.49

1 0 4 - 1938

St. 19
~~Pl.~~
Keenan Ave. No. 7

Name of Owner
Sheeman

Labor and Mat'l. Report Sept 6 1938

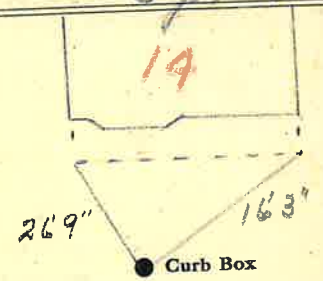

4 Main — Elev. of Main at tap 6

Gate at ● — ● Gate at

● Curb Box

Old Shut off
For Sewer (TM, CUT) (AT MAIN) 2/27/07