Labor and Materials

	Copper / ~~Lead~~ Connection	$ 96
1	Curb — Cock / ~~Valve~~ / ~~T. & V.~~ — in	$ 1.33
1	Service Box Old returned — ~~Short 3½ and 4½~~ / Long 4½x5½ / ~~Buff. or Redwar~~	$ 1.35
13	Ft. ..... in. — ~~Copper~~ / Galv. Iron / ~~Cast Iron~~ Pipe at 15	$ 1.95
	Nipples ..... in. at	$
	Bushings ..... to ..... in. at	$
	Red'g / Inc'g Couplings ..... to ..... in. at	$
	Union ..... in. at	$
	Meter ..... in. at	$
	Lbs. Br. Stone at	$
	Lbs. Sand at	$
	Bags Cement at	$
	Paving Brick — Mack / Red / Asphalt — at	$
	Lead Joints at	$
	Leadite Joints at	$
2	Hrs. ~~Foreman~~ Chauf at 62½	$ 1.25
6	Hrs. Common Labor at 45	$ 2.70
	Hrs. Common Labor at	$
	Hrs. Mason at	$
	Hrs. Masons Helper at	$
	Hrs. Compressor at	$
	Compensation Ins	$ .12
	Trucking	$ 1.—
	Builders Use of Water ½ Sewer	$ 2.50
	Total	$ 13.16

Labor and Material Report

10-36 17 9 1936

10 17/Koeman

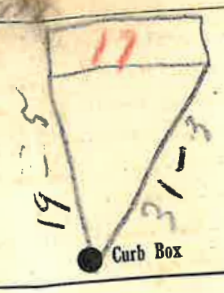

6 Main

Elev. of Main at tap 5

Gate at ● TAX ID # 303.17-22-4 ● Gate at

● Curb Box

New Tap + Sewer