LABOR AND MATERIALS

1	Copper / ~~Lead~~ Connection	3/4"	$	3.04
1	Curb { Cock / ~~Valve~~ / T. S. & V. }	3/4" in.	$	3.54
1	Service box Old returned { Short 3½x4½ / ~~Long 4½x5½~~ / ~~Buff or Rdway~~ }		$	4.70
14	Ft. ~~3/4"~~ in. { Copper / ~~C. I.~~ / ~~C. I.~~ } Pipe at 35		$	4.90
	Nipples in. at		$	
	Bushings to in. at		$	
	Red'g / Inc'g { Coupl'gs to in. at		$	
	Union in. at		$	
	Meter in. at		$	
	Lead Joints at		$	
	Compound Joints at		$	
	Hrs. Water Maint. Man—1 at		$	
13	Hrs. Water Maint. Man—2 at	1.13	$	14.69
17	Hrs. Labor— at	1.02	$	17.34
	Hrs. Labor— at		$	
2	Hrs. Compressor at	1.50	$	3.00
	Compensation Ins. at $ per C.		$	.85
	Trucking		$	1.00
	Pav't Patch		$	9.45
			$	
			$	
			$	
	O'head		$	
			$	62.51

Tap by Crawford
June 11-51

Kensington-Rd St. / Pl. / Ave. No. 2

Name of Owner

Fessler

Labor and Mat'l. Report June 11 19 51

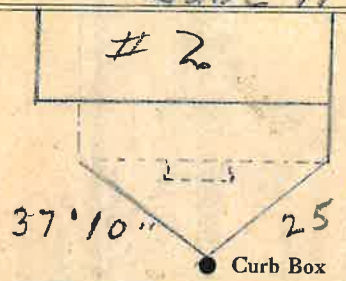

16" Main

Elev. of Main at tap 4'

Gate at ● ● Gate at

● Curb Box

Old Tap Disconnected

LSM-5C 10-21-49