Labor and Materials

Copper / Lead } Connection ..... $.....

Curb { Cock / Valve / T. S. & V. } ..... in ..... $.....

Service Box Old returned { Short 3½ x 4½ / Long 4½ x 5½ / Buff. or Rdway } ..... $.....

.....Ft. .....in. { Copper / Galv Iron / Cast Iron } Pipe at ..... $.....

Nipples .....in. at ..... $.....

Bushings .....to .....in. at ..... $.....

Red'g / Inc'g { Couplings .....to .....in. at ..... $.....

Union .....in. at ..... $.....

Meter .....in. at ..... $.....

Lead Joints at ..... $.....

Leadite Joints at ..... $.....

Hrs. Foreman at ..... $.....

Hrs. Chauffeur at ..... $.....

Hrs. Tapper at ..... $.....

Hrs. Labor at ..... $.....

Hrs. Labor at ..... $.....

Hrs. Compressor at ..... $.....

Compensation Ins. ..... $.....

Trucking ..... $.....

Builders Use of Water ..... $.....

..... $.....

..... $.....

..... $.....

..... $.....

$.....

29-65

St. Pl. Ave. Kensington Ave. No. 34

Name of Owner

Huntop

Labor and Mat'l. Report Sept 30 1937

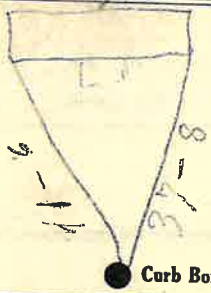

.....Main

Elev. of Main at tap .....

Gate at •

• Gate at

Curb Box

Measurement

By Pump