Labor and Materials

1 Copper ~~Lead~~ Connection 3/4" With 45° El bow $

1 Curb { Cock ~~Valve~~ T. S. & V: } 3/4 in Orisea/ $

1 Service Box { Short 3½ x 4½ ~~Long 4½ x 5½~~ ~~Buff or Rdway~~ } $

19 Ft. 3/4 in. { Copper ~~Galv Iron~~ ~~Cast Iron~~ } Pipe at $

Nipples in. at $

Bushings to in. at $

Red'g Inc'g { Couplings to in. at $

Union in. at $

Meter in. at $

Lead Joints at $

Leadite Joints at $

Hrs. Foreman at $

Hrs. Chauffeur at $

Hrs. Tapper at $

Hrs. Labor at $

Hrs. Labor at $

Hrs. Compressor at $

Compensation Ins. $

Trucking $

Builders Use of Water $

Tap by Gifford & Co. $

6-4-64. $

$

$

Kensington ~~St~~ ~~Pl~~ Rd. Ave. No. 24

Name of Owner

Rena Bennett Davis.

Labor and Mat'l. Report June 4 1964

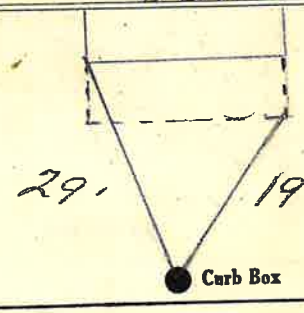

16" Main

Elev. of Main at tap 4'

Gate at

Gate at

Curb Box