Labor and Materials

Copper / Lead	Connection	3/4	$ 1.46
Curb	Cock / ~~Valve~~ / T. S. & V.	in	$ 1.93
Service Box / Old returned	~~Short 3½ x~~ 4½ / Long 4½ x 5½ / Buff. or Rdway		$ 1.77
16 Ft. in.	Copper / ~~Galv. Iron~~ / Cast Iron	Pipe at 3/4	$ 3.52
Nipples	in. at		$
Bushings	to in. at		$
Red'g / Inc'g	Conplings to in. at		$
Union	in. at		$
Meter	in. at		$
Lead Joints at			$
Leadite Joints at			$
1 Hrs. Foreman at	31¼		$ .31
4 Hrs. Chauffeur at	62½		$ 2.50
8 Hrs. Tapper at	62½		$ 5.00
8 Hrs. Labor at	45		$ 3.60
Hrs. Labor at			$
Hrs. Compressor at			$
Compensation Ins.			$ .35
Trucking			$ 1.00
Builders Use of Water	Nogatch		$ —
			$
			$
Tap made by Howell			$
			$
			$ 21.44

126-1937

Kinsington St. Pl. Ave. No. 30

Name of Owner

Schuen

Labor and Mat'l. Report Sept 29, 1937

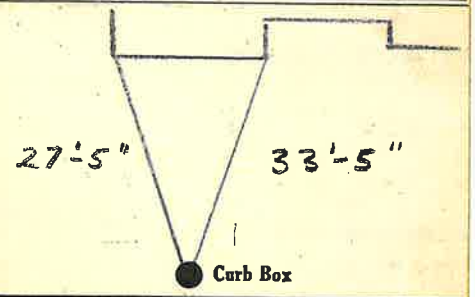

16 Main

Elev. of Main at tap 4½

Gate at

Gate at

Curb Box

old shut off

Remeasured 2-21-77