Labor and Materials

1	Lead Connection	BRASS ¾	$
1	Curb Cock	¾	$
1	Service Box Old returned	Short 3½ x 4½ / ~~Long 4½ x 5½~~ / Buffalo	$
25	Ft.	1 in. Cop G. I. Pipe at	$
1	Nipples	¾ in. at	$
	Bushings	to in. at	$
	Red'g Coup	to in. at	$
1	Inc'g Coup	¾ to 1" in. at	$
	Union	in. at	$
	Meter	in. at	$
	Cu. Yds. Br. Stone at		$
	Cu. Yds. Sand at		$
	Bags Cement at		$
	Paving Brick	Mack / Red / Asphalt at	$
	Hrs. Foreman at		$
	Hrs. Common Labor at		$
	Hrs. Mason at		$
17	Hrs.	at	$
	Hrs.	at	$
	Builders' Use of Water		$
		at	$
		at	$
		at	$
		at	$
	Total		$ 14.81

14

Labor and Material Report

Sept 22 19 20

12 KENWORTHY AVE

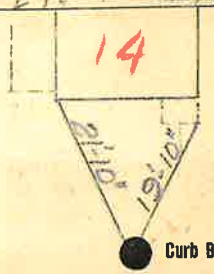

4" Main

Elev. of Main at tap 5"

Gate at ●

● Gate at

● Curb Box