Labor and Materials

Copper / Lead } Connection ..... $ .....

Curb { Cock / Valve / T. S. & V. } ..... in ..... $ .....

Service Box / Old returned { Short 3½ x 4½ / Long 4½ x 5½ / Buff. or Rdway } ..... $ .....

..... Ft. ..... in. { Copper / Galv Iron / Cast Iron } Pipe at ..... $ .....

Nipples ..... in. at ..... $ .....

Bushings ..... to ..... in. at ..... $ .....

Red'g / Inc'g } Couplings ..... to ..... in. at ..... $ .....

Union ..... in. at ..... $ .....

Meter ..... in. at ..... $ .....

Lead Joints at ..... $ .....

Leadite Joints at ..... $ .....

Hrs. Foreman at ..... $ .....

Hrs. Chauffeur at ..... $ .....

Hrs. Tapper at ..... $ .....

Hrs. Labor at ..... $ .....

Hrs. Labor at ..... $ .....

Hrs. Compressor at ..... $ .....

Compensation Ins. ..... $ .....

Trucking ..... $ .....

Builders Use of Water ..... $ .....

..... $ .....

..... $ .....

..... $ .....

..... $ .....

$ .....

~~St.~~ / Pl. 14


Name of Owner

Labor and Mat'l. Report april 1 1908

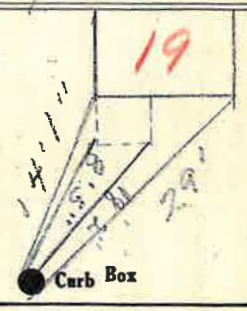

..... Main

Elev. of Main at tap ....

Gate at ● ● Gate at

● Curb Box

14' 1" 8' 5" 18' 2" 29'