LABOR AND MATERIALS

1	Copper ~~Lead~~ Connection 3/4	$1.35
1	Curb { Cock / Valve / T. S. & V. } 3/4 in.	$1.88
1	Service Box Old returned { Short 3½x4½ / Long 4½x5½ / Buff. or Rdway }	$1.82
30	Ft. 3/4 in. { Copper / Galv Iron / Cast Iron } Pipe at 20	$6.00
	Nipples ____ in. at	$
	Bushings ____ to ____ in. at	$
	Red'g / Inc'g Couplings ____ to ____ in. at	$
	Union ____ in. at	$
	Meter ____ in. at	$
	Lead Joints at	$
	Leadite Joints at	$
	Hrs. Foreman at	$
4	Hrs. Chauffeur at 68¾	$2.75
10	Hrs. Tapper at	$6.88
8	Hrs. Labor at 55	$4.40
	Hrs. Labor at	$
	Hrs. Compressor at	$
	Compensation Ins.	$ .43
	Trucking	$1.—
	Builders Use of Water Patch	$5.00
	Tag & Hassel	$
		$
		$
		$
		$31.51

H.

15 1942

~~St.~~
~~Pl.~~
Kenworthy Ave. No. 21

Name of Owner

Ward

Labor and Mat'l. Report May 1 1942

26A-B

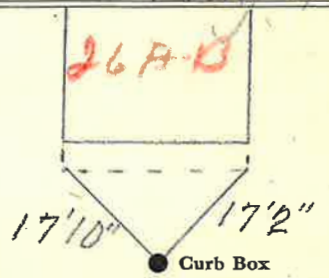

6 Main

Elev. of Main at tap 6

Gate at ● ● Gate at

TAX ID # 302.12-20-10

● Curb Box