LABOR AND MATERIALS

1	Copper / Lead Connection 3/4		$ 1.79
1	Curb Clock / Valve / T. S. & V. 3/4 in.		$ 2.61
1	Service box / Old returned Short 3½X4½ / Long 4½X5½ / Buff or Rdway		$ 1.82
10	Ft. 3/4 in. Copper / Galv. Iron / Cast Iron Pipe at 23		$ 2.30
	Nipples in. at		$
1	Bushings ½ to 3/4 in. at Brass		$
	Red'g / Inc'g Couplings to in. at		$
	Union in. at		$
	Meter in. at		$
	Lead Joints at		$
	Compound Joints at		$
	Hrs. Foreman at		$
5	Hrs. Chauffeur at	82½	$ 4.12
	Hrs. Tapper at		$
12	Hrs. Labor at	71½	$ 8.58
	Hrs. Labor at		$
1	Hrs. Compressor at	87½	$ 88
	Compensation Ins.		$ 35
	Trucking		$ 1.00
	Builders Use of Water		$ 5.00
	Tap & Warsuck		$
			$
			$
			$
			$ 28.45

12.70

✓

44- 46

Kenworthy

St. Pl. Ave. No. 9

Name of Owner

Whitney

Labor and Mat'l. Report Aug 30 19

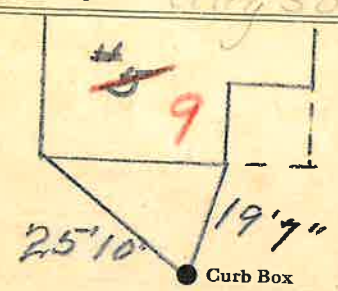

4" Main

Elev. of Main at tap 5

Gate at

Gate at

Curb Box

LSM-5C-6-1-45