## LABOR AND MATERIALS

| | | |
|---|---|---|
| 1 Copper ~~Lead~~ Connection 3/4 | | $ 1.78 |
| 1 Curb Clock ~~Valve~~ ~~T. S. & V.~~ 3/4 in. | | $ 2.61 |
| 1 Service box Old returned Short 3½X4½ ~~Long 4½X5½~~ Buff or Rdway | | $ 1.82 |
| 13 Ft. 3/4 in. Copper ~~Galv. Iron~~ ~~Cast Iron~~ Pipe at 23 | | $ 2.99 |
| Nipples in. at | | $ |
| Bushings to in. at | | $ |
| Red'g Inc'g Couplings to in. at | | $ |
| Union in. at | | $ |
| Meter in. at | | $ |
| Lead Joints at | | $ |
| Compound Joints at | | $ |
| Hrs. Foreman at | | $ |
| Hrs. Chauffeur at | | $ |
| 4 Hrs. Tapper at | 75 | $ 3.00 |
| 7 Hrs. Labor at | 65 | $ 4.55 |
| Hrs. Labor at | | $ |
| Hrs. Compressor at | | $ |
| Compensation Ins. | | $ .20 |
| Trucking | | $ 1.00 |
| Builders Use of Water | | $ 5.00 |
| Tap by Mcguinn | | $ |
| | | $ |
| | | $ |
| | | $ |
| | | $ 22.95 |

23-46

Kenworthy ~~Str.~~ ~~Pl.~~ Ave. No. ~~7~~ 11

Name of Owner

Coulter

Labor and Mat'l. Report May 6 1946

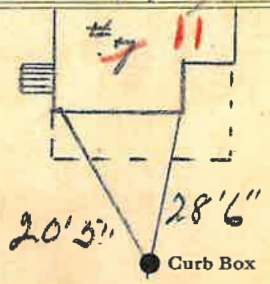


4" Main

Elev. of Main at tap 5

Gate at ● ● Gate at

TAX ID # 302.12-21-18

● Curb Box

LSM-5C-6-1-45