LABOR AND MATERIALS

1 ~~Copper~~ ~~Lead~~ Connection 3/4 $_____

1 Curb ~~Cock~~ ~~Valve~~ ~~T. S. & V.~~ 3/4 in. $_____

1 Service box ~~Old returned~~ ~~Short 3½ x 4½~~ Long 4½ x 5½ ~~Buff or Rdway~~ $_____

16' Ft. 3/4 in. ~~Copper~~ ~~C.I.~~ ~~C.I.~~ Pipe at $_____

____ Nipples ____ in. at ____ $_____

____ Bushings ____ to ____ in. at ____ $_____

____ Red'g Inc'g Coupl'gs ____ to ____ in. at ____ $_____

____ Union ____ in. at ____ $_____

____ Meter ____ in. at ____ $_____

____ Lead Joints at ____ $_____

____ Compound Joints at ____ $_____

____ Maintenance Foreman ____ $_____

____ Hrs. Water Maint. Man—1 at ____ $_____

____ Hrs. Water Maint. Man—2 at ____ $_____

____ Hrs. Garage Foreman ____ at ____ $_____

____ Hrs. Labor— ____ at ____ $_____

____ Hrs. Compressor at ____ $_____

____ Compensation Ins. at $____ per C ____ $_____

____ Trucking ____ $_____

____ Pav't Patch ____ $_____

____ $_____

Tap 11/29/78 $_____

Beecher & Co. $_____

____ O'head ____ $_____

$_____

St. Pl. Ave. No. Kidder Lane 3

Name of Owner

Gary Greene

Labor and Mat'l. Report Nov. 29 1978

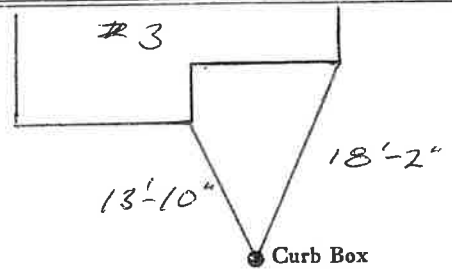

8 Main Elev. of Main at tap 5'

Gate at ● ● Gate at

● Curb Box

LSM—5C—6-1-67