LABOR AND MATERIALS

Copper / Lead } Connection _____ $_____

_____ Curb { Cock / Valve / T. S. & V. } _____ in. _____ $_____

_____ Service box / Old returned { Short 3½ x 4½ / Long 4½ x 5½ } _____ $_____

_____ Ft. 3/4 in. { Copper / ~~G. I.~~ / ~~C. I.~~ } Pipe at _____ $_____

_____ Nipples _____ in. at _____ $_____

_____ Bushings _____ to _____ in. at _____ $_____

Red'g / Inc'g } Coupl'gs _____ to _____ in. at _____ $_____

_____ Union _____ in. at _____ $_____

_____ Meter _____ in. at _____ $_____

_____ _____ $_____

_____ Compound Joints at _____ $_____

_____ Maintenance Foreman _____ $_____

_____ Hrs. Water Maint. Man—1 at _____ $_____

_____ Hrs. Water Maint. Man—2 at _____ $_____

_____ Hrs. Garage Foreman _____ at _____ $_____

_____ Hrs. Labor— _____ at _____ $_____

_____ Hrs. Compressor at _____ $_____

_____ $_____

_____ Trucking _____ $_____

_____ Pav't Patch _____ $_____

_____ $_____

_____ $_____

_____ $_____

_____ $_____

$_____

KNIGHT St. ~~Pl.~~ Ave. No. 24

Name of Owner

Labor and Mat'l. Report 19 74

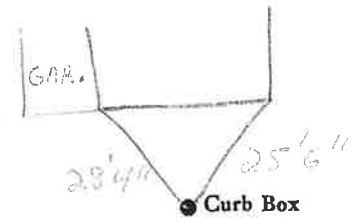

_____ Main

Elev. of Main at tap _____

Gate at ●

● Gate at

● Curb Box

LSM—5C—6-1-67

Labor and Materials

Cop. ~~Lead Connections~~ 3/4 ..... $.....

1 Curb Cock 3/4 ..... $.....

1 Service Box Old returned { ~~Short 6½ x 4½~~ Long 4½ x 5½ ~~Buffalo~~ } $.....

10 Ft. 3/4 Cop in. G. I. Pipe at ..... $.....

..... Nipples ..... in. at ..... $.....

..... Bushings ..... to ..... in. at ..... $.....

..... Red'g Coup .... to .... in. at ..... $.....

..... Inc'g Coup .... to .... in. at ..... $.....

..... Union .... in. at ..... $.....

..... Meter .... in. at ..... $.....

..... Cu. Yds. Br. Stone at ..... $.....

..... Cu. Yds. Sand at ..... $.....

..... Bags Cement at ..... $.....

..... Paving Brick { Mack Red Asphalt } at ..... $.....

2½ Hrs. Foreman at ..... $.....

Ab 4 Hrs. Common Labor at ..... $.....

..... Hrs. Mason at ..... $.....

..... Hrs. ..... at ..... $.....

..... Hrs. ..... at ..... $.....

10 Builders' Use of Water ..... $.....

..... at ..... $.....

Lunch ..... at ..... $.....

..... at ..... $.....

..... at ..... $.....

Total $ 14.11

Labor and Material Report Aug. 1925

? 24 Knight St.

Curb Box

Elev. of Main at tap

Main

Gate at

Gate at

Curb Box