LABOR AND MATERIALS

1	Copper Lead } Connection 3/4	$ 1.78
1	Curb { Clock Valve T. S. & V. } 3/4 in.	$ 2.61
1	Service box Old-returned { Short 3½X4½ Long 4½X5½ Buff or Rdway }	$ 1.82
21 Ft. 3/4 in.	{ Copper Galv. Iron Cast Iron } Pipe at 23	$ 4.83
	Nipples ... in. at ...	$
	Bushings ... to ... in. at ...	$
	Red'g Inc'g } Couplings ... to ... in. at ...	$
	Union ... in. at ...	$
	Meter ... in. at ...	$
	Lead Joints at ...	$
	Compound Joints at ...	$
	Hrs. Foreman at ...	$
4	Hrs. Chauffeur at .75	$ 3.00
4	Hrs. Tapper at .65	$ 2.60
	Hrs. Labor at ...	$
	Hrs. Labor at ...	$
	Hrs. Compressor at ...	$
	Compensation Ins.	$ .15
	Trucking	$ 1.00
	Builders Use of Water Paid?	$ 5.00
Tap to Wrapped		$
		$
		$
		$
		$22.79

39 1946 Knight St. F 38 28

Haviland Ave St. Pl. Ave. No.

Name of Owner

Howell

Labor and Mat'l. Report June 29 1946

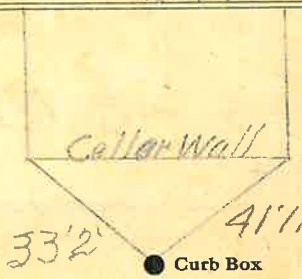

1 Main

Elev. of Main at tap 5"

Gate at ● ● Gate at

● Curb Box

LSM-5C-6-1-45