Labor and Materials

	Lead Connection	$
1	Curb Cock 3/4	$
1	Service Box Old returned { ~~Short 3½ x 4½~~ / Long 4½ x 5½ / ~~Buffalo~~ }	$
8	Ft. 3/4 in. ~~G. I.~~ Pipe at	$
	Nipples ..... in. at	$
	Bushings ..... to ..... in. at	$
	Red'g Coup .... to .... in. at	$
	Inc'g Coup .... to .... in. at	$
	Union .... in. at	$
	Meter .... in. at	$
	Cu. Yds. Br. Stone at	$
	Cu. Yds. Sand at	$
	Bags Cement at	$
	Paving Brick { Mack / Red / Asphalt } at	$
4	Hrs. Foreman at	$
8¾	Hrs. Common Labor at	$
	Hrs. Mason at	$
	Hrs. ..... at	$
	Hrs. ..... at	$
	Builders' Use of Water	$
	Truck at	$
	at	$
	at	$
	at	$
	Total	$

Labor and Material Report

Aug 26 1925

6 Knight St.

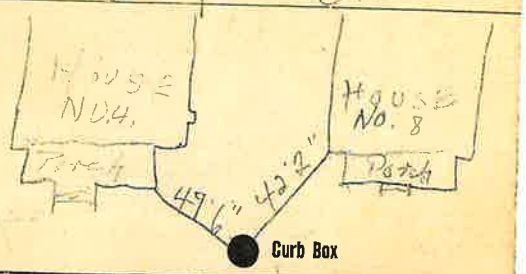

Main

Elev. of Main at tap

Gate at

Gate at

Curb Box