Labor and Materials

1	Copper / ~~Lead~~ Connection	3/4"	$ 1.46
1	Curb — Cock / ~~Valve~~ / ~~T. S. & V.~~	3/4" in	$ 1.93
1	Service Box — ~~Short 3½ x 4½~~ / Long 4½ x 5½ / ~~Buff. or Rdway~~		$ 1.77
24	Old returned		
~~24~~ 22	Ft. ~~3/4"~~ in. — Copper / ~~Galv Iron~~ / ~~Cast Iron~~ Pipe at	22	$ 5.72
	Nipples in. at		$
	Bushings to in. at		$
	Red'g / Inc'g Couplings to in. at		$
	Union in. at		$
	Meter in. at		$
	Lead Joints at		$
	Leadite Joints at		$
	Hrs. Foreman at		$
3	Hrs. Chauffeur at	62½	$ 1.88
	Hrs. Tapper at		$
14	Hrs. Labor at	45	$ 6.30
	Hrs. Labor at		$
	Hrs. Compressor at		$
	Compensation Ins.		$ .25
	Trucking		$ 1.00
	Builders Use of Water	Patch (Sewer)	$ 2.50
			$
			$
			$
	Tap made by Penn		$
			$ 22.81

1 7–1937

Knight St. / ~~Pl.~~ / ~~Ave.~~ No. 64½

Name of Owner

George Bucnys

Labor and Mat'l. Report May 2 1937

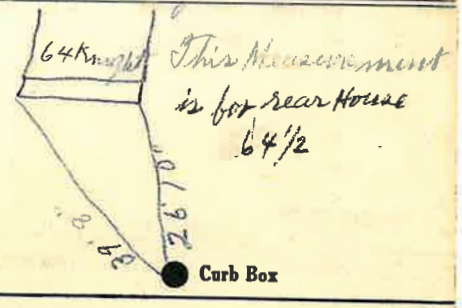

4" Main — 12" 1971 — Elev. of Main at tap 5 4½

Gate at • — • Gate at

TAX ID # 309.15-4-20

• Curb Box

New tap