Labor and Materials

	Lead Connection 3/4	$
1	Curb Cock 3/4	$
1	Service Box (Short 3½ x 4½ / Old returned (Long / Buffalo)	$
30	Ft. 3/4 in. C.I. Pipe at	$
	Nipples in. at	$
1	Bushings 3/4 to 1/2 in. at	$
	Red'g Coup to in. at	$
	Inc'g Coup to in. at	$
	Union in. at	$
	Meter in. at	$
	Cu. Yds. Br. Stone at	$
	Cu. Yds. Sand at	$
	Bags Cement at	$
	Paving Brick (Mack / Red / Asphalt) at	$
2 3/4	Hrs. Foreman at	$
11 3/4	Hrs. Common Labor at	$
	Hrs. Mason at	$
1	Hrs. Baked at	$
	Hrs. at	$
72	Builders' Use of Water	$
	at	$
	at	$
	at	$
	at	$
	Total	$ 19.01

Labor and Material Report Aug. 1925

73 Knight St.

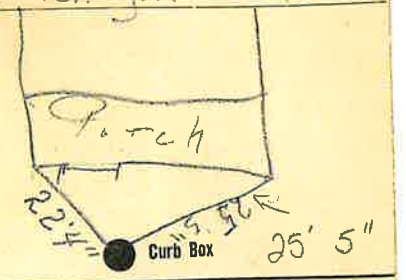

Main — Elev. of Main at tap

Gate at ● ● Gate at