LABOR AND MATERIALS

1 Copper ~~Lead~~ } Connection 3/4		$ 1.59
1 Curb { Cock ~~Valve~~ ~~T. S. & V.~~ } 3/4 in.		$ 2.74
1 Service Box ~~Old returned~~ 6	{ Short 3½x4½ / Long 4½x5½ / Buff or Rdway }	$ 1.82
~~4~~ Ft. 3/4 in.	{ Copper / Galv Iron / Cast Iron } Pipe at 19	$ 76
Nipples ..... in. at		$
Bushings ..... to ..... in. at		$
Red'g / Inc'g } Couplings ..... to ..... in. at		$
Union ..... in. at		$
Meter ..... in. at		$
Lead Joints at		$
Leadite Joints at		$
Hrs. Foreman at		$
2 Hrs. Chauffeur at	68 3/4	$ 1.38
Hrs. Tapper at		$
2 Hrs. Labor at	.60	$ 1.20
Hrs. Labor at		$
Hrs. Compressor at		$
Compensation Ins.		$ .09
Trucking		$ 1.00
Builders Use of Water		$ 5.00
Tap by Warsinski		$
		$
		$
		$
		$ 15.58

10-45

Knight St. ~~Pl.~~ ~~Ave.~~ No. 71

Name of Owner

Potter

Labor and Mat'l. Report May 7 1945

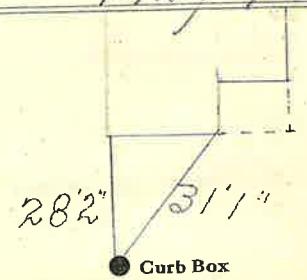

12" 1971

~~4~~ Main

Elev. of Main at tap 5 1/2

Gate at ●

● Gate at

● Curb Box