LABOR AND MATERIALS

1	Copper Lead } Connection	3/4	$ 2.94
1	Curb { Clock Valve T. S. & V. }	3/4 in.	$ 3.71
1	Service box Old returned { Short 3½X4½ Long 4½X5½ Buff or Rdway }		$ 5.90
22	Ft. 3/4 in. { Copper Galv. Iron Cast Iron } Pipe at 30		$ 6.60
	Nipples ... in. at ...		$
	Bushings ... to ... in. at ...		$
	Red'g Inc'g } Couplings ... to ... in. at ...		$
	Union ... in. at ...		$
	Meter ... in. at ...		$
	Lead Joints at ...		$
	Compound Joints at ...		$
6	Hrs. ~~Foreman~~ at WMM-1	101	$ 6.06
4	Hrs. ~~Chauffeur~~ at WMM-2	91	$ 3.64
	Hrs. Tapper at ...		$
12	Hrs. Labor at	80	$ 9.60 19.30
	Hrs. Labor at ...		$
	Hrs. Compressor at ...		$ .43
	Compensation Ins. ...		$ —
	Trucking ...		$ 8.00
	Builders Use of Water ...		$
	Tap by Miller		$
			$
			$
			$ 47.88

9

St. / ~~Pl.~~ Ave. No. 14

LaRose

Name of Owner

Davenport

Labor and Mat'l. Report Nov. 8 19 45

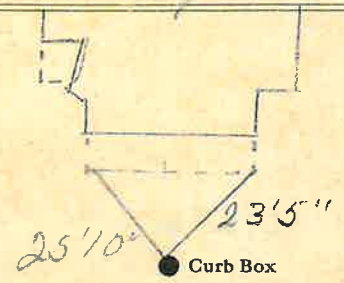

6" Main

Elev. of Main at tap 4 ft

Gate at ● ● Gate at

● Curb Box

LSM-5C-6-1-45