LABOR AND MATERIALS

1	Copper / Lead Connection 3/4	$ 2.87
1	Curb — Cock / Valve / T. S. & V. 3/4 in.	$ 3.67
1	Service box — Old returned — Short 3½X4½ / Long 4½X5½ / Buff or Rdway	$ 4.68
8 Ft. 3/4 in.	Copper / G. I. / C. I. Pipe at 37	$ 2.56
	Nipples ..... in. at	$ .....
	Bushings ..... to ..... in. at	$ .....
	Red'g / Inc'g Coupl'gs ..... to ..... in. at	$ .....
	Union ..... in. at	$ .....
	Meter ..... in. at	$ .....
	Lead Joints at	$ .....
	Compound Joints at	$ .....
	Hrs. Water Maint. Man—1 at	$ .....
3	Hrs. Water Maint. Man—2 at 1.02	$ 3.06
12	Hrs. Labor— ....at 91	$ 10.92
	Hrs. Labor— ....at	$ .....
	Hrs. Compressor at	$ .....
	Compensation Ins. at $ 2.18 per C	$ .30
	Trucking	$ 2.50
	Pav't Patch	$ .....
	Total Maximum 5	$ .....
	.....	$ .....
	O'head	$ .....
		$ 30.01

50

St.

La Rose Pl. Ave. No. 69

Name of Owner

McFadden

Labor and Mat'l. Report Oct 13 1949

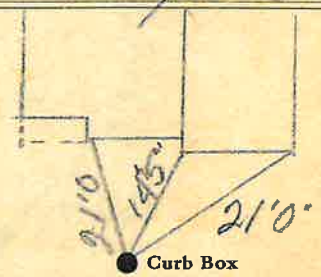

6 Main

Elev. of Main at tap 5

Gate at ● ● Gate at

● Curb Box

LSM-5C 8 15-48 Take Billed