LABOR AND MATERIALS

1	Copper / ~~Lead~~ Connection	3/4	$ 5.80
1	Curb { Clock / Valve / T. S. & V. }	3/4 in.	$ 3.60
1	Service box Old returned { ~~Short 3½X4½~~ / ~~Long 4½X5½~~ / Buff or Rdway }		$ 5.80
32	Ft. 3/4 in. { Copper / Galv. Iron / ~~Cast Iron~~ }	Pipe at ~~35~~	$ 11.20
	Nipples	in. at	$
	Bushings	to in. at	$
	Red'g / Inc'g Couplings	to in. at	$
	Union	in. at	$
	Meter	in. at	$
	Lead Joints at		$
	Compound Joints at		$
	Hrs. Foreman at		$
	Hrs. Chauffeur at		$
2	Hrs. Tapper at	91	$ 1.82
9	Hrs. Labor at	80	$ 7.20
	Hrs. Labor at		$
	Hrs. Compressor at		$
	Compensation Ins.		$ .20
	Trucking		$ 1.—
	Builders Use of Water		$ 5.80
	Todd Maguire		$
			$
			$
			$
			$ 39.42

145/47

Lake ~~St.~~ ~~Pl.~~ Ave. No. 9

Name of Owner

Houseman

Labor and Mat'l. Report Oct 22 19 47

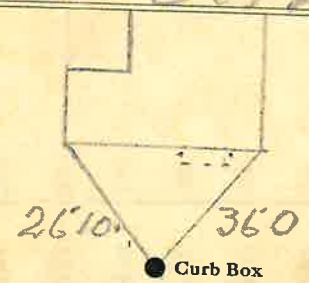

6 Main — Elev. of Main at tap 4½

Gate at ● ● Gate at

● Curb Box

LSM-5C-6-1-45