LABOR AND MATERIALS

1	Copper ~~Lead~~ Connection 3/4		$ 1.35
1	Curb Cock ~~Valve~~ ~~T. S. & V.~~ 3/4 in.		$ 1.80
1	Service Box ~~Old returned~~ Short 3½x4½ ~~Long 4½x5½~~ ~~Buff or Rdway~~		$ 1.70
8	Ft. 3/4 in. Copper ~~Galv Iron~~ ~~Cast Iron~~ Pipe at 18		$ 1.98
	Nipples ..... in. at		$
	Bushings ..... to ..... in. at		$
	Red'g Inc'g Couplings ..... to ..... in. at		$
	Union ..... in. at		$
	Meter ..... in. at		$
	Lead Joints at		$
	Leadite Joints at		$
	Hrs. Foreman at		$
2	Hrs. Chauffeur at	.62½	$ 1.25
4	Hrs. Tapper at	"	$ 2.50
4	Hrs. Labor at	45	$ 1.80
	Hrs. Labor at		$
1/2	Hrs. Compressor at		$ .31
	Compensation Ins.		$ .17
	Trucking		$ 1.—
	Builders Use of Water	1/2 Patch (sewer)	$ 2.50
	Tap by Hessel		$
			$
			$
			$
			$ 16.36

5 1941

Lake ~~St.~~ ~~Pl.~~ Ave. No. 14

Name of Owner

Fisher

Labor and Mat'l. Report May 1 1941

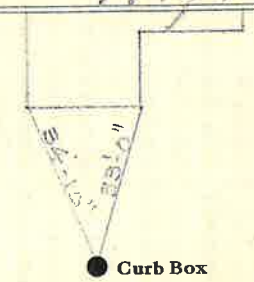

6 Main

Elev. of Main at tap 5

Gate at ● ● Gate at

● Curb Box

NEW COPPER 4-21-94