LABOR AND MATERIALS

1	Copper ~~Lead~~ Connection 3/4	$ 1.35
1	Curb { Cock ~~Valve~~ ~~T. S. & V.~~ } 3/4 in.	$ 1.80
	Service Box Old returned { Short 3½x4½ Long 4½x5½ Buff or Rdway } Same Box	$ —
24	Ft. 3/4 in. { Copper ~~Galv Iron~~ ~~Cast Iron~~ } Pipe at 18	$ 4.32
	Nipples ... in. at ...	$
	Bushings ... to ... in. at ...	$
	Red'g Inc'g } Couplings ... to ... in. at ...	$
	Union ... in. at ...	$
	Meter ... in. at ...	$
	Lead Joints at ...	$
	Leadite Joints at ...	$
	Hrs. Foreman at ...	$
6	Hrs. Chauffeur at 62½	$ 3.75
	Hrs. Tapper at ...	$
15	Hrs. Labor at ...	$ 6.75
	Hrs. Labor at ...	$
	Hrs. Compressor at ...	$
	Compensation Ins.	$ .32
	Trucking ...	$ 1.—
	Builders Use of Water Ditch	$ 9.—
	Tapping Plug	$
		$
		$
		$
		$ 28.29

2 9 1941

St. 29
~~Pl.~~
~~Ave.~~ No. 21 Lawrence

Name of Owner

Sheffer

Labor and Mat'l. Report May 22 1941

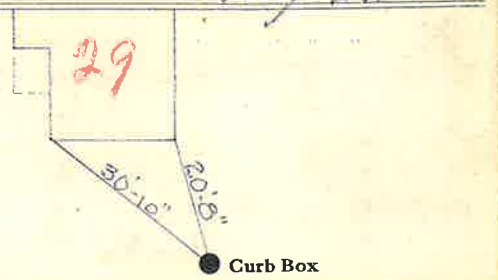

12 Main

Elev. of Main at tap 4½

Gate at ●

● Gate at

● Curb Box