Labor and Materials

1 Lead Connection 3/4 ..... $.....

1 Curb Cock 3/4 ..... $.....

1 Service Box { Short 3½ x 4 / Long 4½ x 5½ / Buffalo } Old returned ..... $.....

10 Ft. ..... in. G.I. Pipe at 3/4 Cock ..... $.....

..... Nipples ..... in. at ..... $.....

1 Bushings 3/4 ..... to 1/2 ..... in. at ..... $.....

..... Red'g Coup ..... to ..... in. at ..... $.....

..... Inc'g Coup ..... to ..... in. at ..... $.....

..... Union ..... in. at ..... $.....

..... Meter ..... in. at ..... $.....

..... Cu. Yds. Br. Stone at ..... $.....

..... Cu. Yds. Sand at ..... $.....

..... Bags Cement at ..... $.....

..... Paving Brick { Mack / Red / Asphalt } at ..... $.....

2 Hrs. Foreman at ..... $.....

10 Hrs. Common Labor at ..... $.....

..... Hrs. Mason at ..... $.....

1 Hrs. ..... at ..... $.....

..... Hrs. ..... at ..... $.....

Dus Builders' Use of Water ..... $.....

..... at ..... $.....

Truck 10.00 ..... at ..... $.....

..... at ..... $.....

..... at ..... $.....

Total $

36

Labor and Material Report Sept 2

98 LAWRENCE ST.

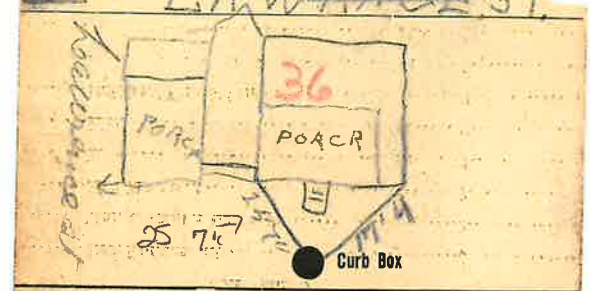

1½" Main

Elev. of Main at tap 5'

Gate at ●

● Gate at

● Curb Box

TAP FROM CHERRY ST