St.
~~Pl.~~
~~Ave.~~ No. 35 41

Lawrence

Name of Owner

Labor and Mat'l. Report May 13 1932

See Below
#
41 + 43
Lawrence st
Were on
Same Tap.

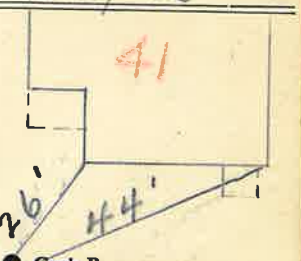

Both houses Razed.

12" Main — see Card for #43. — Elev. of Main at tap 5'

Gate at ● ● Gate at

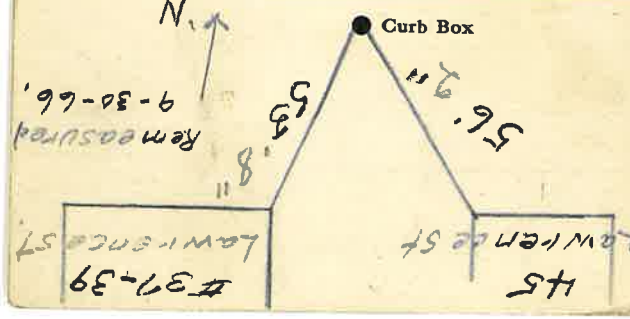

St.
~~Pl.~~
~~Ave.~~ No. 35 41

Lawrence

Name of Owner

Labor and Mat'l. Report May 13 1932

See Below
#
41 + 43
Lawrence st
Were on
Same Tap.

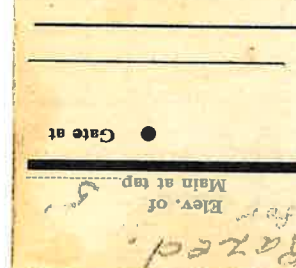

Both houses Razed.
see Card for #43.

12" Main — Elev. of Main at tap 5'

Gate at ● ● Gate at

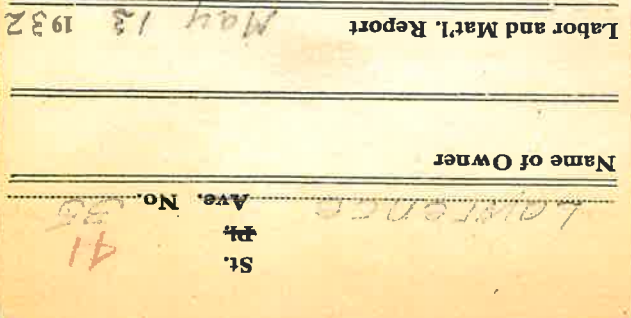

LABOR AND MATERIALS

1 Copper / ~~Lead~~ } Connection 3/4" $

1 Curb { Cock / Valve / ~~T. S. & V.~~ } 3/4 in. $

1 Service Box Old returned { ~~Short 3½x4½~~ / Long 4½x5½ / ~~Buff. or Rdway~~ } $

26 Ft. 3/4 in. { Copper / ~~Galv Iron~~ / ~~Cast Iron~~ } Pipe at $

Nipples in. at $

Bushings to in. at $

Red'g / Inc'g } Couplings to in. at $

Union in. at $

Meter in. at $

Lead Joints at $

Leadite Joints at $

Hrs. Foreman at $

Hrs. Chauffeur at $

Hrs. Tapper at $

Hrs. Labor at $

Hrs. Labor at $

Hrs. Compressor at $

Compensation Ins. $

Trucking $

Builders Use of Water $

$

$

$

$

$

$