## LABOR AND MATERIALS

| | | |
|---|---|---|
| 1 Copper ~~Lead~~ | Connection 3/4 | $ 1.35 |
| 1 Curb { Cock / Valve / T. S. & V. } | 3/4 in. | $ 1.98 |
| Save Service Box Old returned { Short 3½x4½ / Long 4½x5½ / Buff. or Rdway } | | $ 1.87 |
| 4 Ft. 3/4 in. { Copper / ~~Galv Iron~~ / ~~Cast Iron~~ } | Pipe at 20 | $ .80 |
| ____ Nipples ____ in. at | | $ |
| ____ Bushings ____ to ____ in. at | | $ |
| ____ Red'g / Inc'g } Couplings ____ to ____ in. at | | $ |
| ____ Union ____ in. at | | $ |
| ____ Meter ____ in. at | | $ |
| ____ Lead Joints at | | $ |
| ____ Leadite Joints at | | $ |
| ____ Hrs. Foreman at | | $ |
| 6 Hrs. Chauffeur at | 68¾ | $ 4.12 |
| 2 Hrs. Tapper at | | $ 1.38 |
| 8 Hrs. Labor at | 55 | $ 4.40 |
| ____ Hrs. Labor at | | $ |
| ____ Hrs. Compressor at | | $ |
| ____ Compensation Ins. | | $ .31 |
| ____ Trucking | | $ 1.— |
| ____ Builders Use of Water 1" meter (Sewer) | | $ 4.50 |
| Tap Wm. Marsh | | $ |
| | | $ |
| | | $ |
| | | $ |
| | | $21.51 |

H.

1 3 1942

St. 44
Pl. :
Lawrence Ave. No. 38

**Name of Owner**

Fincher

**Labor and Mat'l. Report** Oct 30 1942

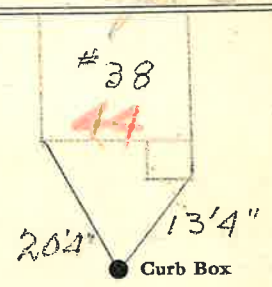


12" Main — Elev. of Main at tap 34'

Gate at ● ● Gate at

● Curb Box

H