LABOR AND MATERIALS

1	Copper ~~Lead~~ Connection	3/4	$ 2.80
1	Curb { Clock / Valve / ~~T. S. & V.~~ }	3/4 in.	$ 3.60
1	Service box Old returned { Short 3⅛X4⅛ / Long 4⅛X5⅛ / Buff or Rdway }		$ 5.80
33 Ft.	3/4 in. { Copper / Galv. Iron / ~~Cast Iron~~ }	Pipe at 35	$ 11.55
	Nipples in. at		$
	Bushings to in. at		$
	Red'g / Inc'g Couplings to in. at		$
	Union in. at		$
	Meter in. at		$
	Lead Joints at		$
	Compound Joints at		$
	Hrs. Foreman at		$
9	Hrs. Chauffeur at	82½	$ 7.42
4	Hrs. Tapper at	82½	$ 3.30
2.4	Hrs. Labor at	71½	$ 19.16
	Hrs. Labor at		$
2	Hrs. Compressor at	87½	$ 1.75
	Compensation Ins.		$ .66
	Trucking		$ 1
	Builders Use of Water		$ 10.50
	Tap by Warsinske		$
			$
			$
			$
			$ 67.54

14-17

Lawrence St. Pl. ~~Ave.~~ No. 53

Name of Owner

Lambert

Labor and Mat'l. Report May 2 1947

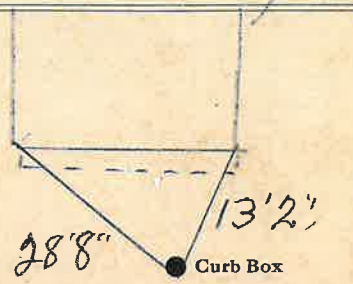

12 Main

Elev. of Main at tap 6

Gate at ● ● Gate at

● Curb Box

LSM-5C-6-1-45