LABOR AND MATERIALS

1 Copper / Lead } Connection 3/4" ..... $.....

1 Curb { Clock / Valve / T. S. & V. } 3/4 in. ..... $.....

1 Service box / Old returned { Short 3½X4½ / Long 4½X5½ / Buff or Rdway } ..... $.....

5/8 Ft. 3/4 in. { Copper / Galv. Iron / Cast Iron } Pipe at ..... $.....

..... Nipples ..... in. at ..... $.....

..... Bushings ..... to ..... in. at ..... $.....

..... Red'g / Inc'g } Couplings ..... to ..... in. at ..... $.....

..... Union ..... in. at ..... $.....

..... Meter ..... in. at ..... $.....

..... Lead Joints at ..... $.....

..... Compound Joints at ..... $.....

..... Hrs. Foreman at ..... $.....

..... Hrs. Chauffeur at ..... $.....

..... Hrs. Tapper at ..... $.....

7 Hrs. Labor at ..... $.....

2 Hrs. Labor at ..... $.....

..... Hrs. Compressor at ..... $.....

..... Compensation Ins. ..... $.....

..... Trucking ..... $.....

..... Builders Use of Water ..... $.....

Marsinski & Geo ..... $.....

..... $.....

..... $.....

..... $.....

..... $.....

$.....

---

84 A-B

Lawrence St. / Pl. / Ave. No. 58

Name of Owner

TAX ID # 303.17-4-7

Labor and Mat'l. Report July 1945

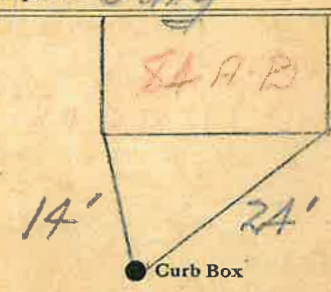

12" Main

Elev. of Main at tap 5'

Gate at ●

● Gate at

● Curb Box

LSM-5C-6-1-45