LABOR AND MATERIALS

1	Copper ~~Lead~~ Connection	3/4"	$ 2.76
1	Curb Cock ~~Valve~~ ~~T. S. & V.~~	3/4 in.	$ 3.49
1	Service box ~~Old returned~~ Short 3½X4½ Long 4½X5½ ~~Buff or Rdway~~		$ 4.74
11	Ft. 3/4 in. Copper ~~G. I.~~ ~~C. I.~~	Pipe at 35	$ 3.85
	Nipples in. at		$
	Bushings to in. at		$
	Red'g Inc'g Coupl'gs to in. at		$
	Union in. at		$
	Meter in. at		$
	Lead Joints at		$
	Compound Joints at		$
2	Hrs. Water Maint. Man—1 at		$
2	Hrs. Water Maint. Man—2 at	12.4	$ 2.48
18	Hrs. Labor— at	13	$ 20.34
	Hrs. Labor— at		$
	Hrs. Compressor at		$
	Compensation Ins. at $3.706 per C		$ .85
	Trucking		$ 1.50
	Pav't Patch		$ 25.88
Tap by Gifford 10-29-52			$
			$
			$
	O'head		$
			$ 66.39

St.
~~Pl.~~ Lawrence ~~Ave.~~ No. 97

Name of Owner

Snow

Labor and Mat'l. Report Oct. 29 1952

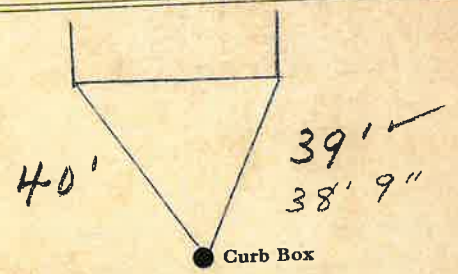

4" Main

Elev. of Main at tap 5½'

Gate at ●

● Gate at

● Curb Box

Tap on Prospect St.

LSM-SC 5 15-48