LABOR AND MATERIALS

1	Copper Lead — Connection	3/4	$ 2.76
1	Curb — Cock / Valve / T. S. & V.	3/4 in.	$ 3.49
1	Service box — Short 3½X4½ / Long 4½X5½ / Buff or Rdway		
1	Old returned		$ 4.79
20	Ft. 3/4 in. — Copper / G. I. / C. I.	Pipe at 38	$ 7.60
	Nipples ... in. at		$
	Bushings ... to ... in. at		$
	Red'g / Inc'g — Coupl'gs ... to ... in. at		$
	Union ... in. at		$
	Meter ... in. at		$
	Lead Joints at		$
	Compound Joints at		$ 1.43
	Hrs. Water Maint. Man—1 at		$
19	Hrs. Water Maint. Man—2 at	1.24	$ 23.56
26	Hrs. Labor— ... at	1.13	$ 40.68
	Hrs. Labor— ... at		$
	Hrs. Compressor at		$
	Compensation Ins. at $ 4.06 per C		$ 2.83
	Trucking		$ 1.—
	Pav't Patch		$ 26.10
	Tap by Gifford 5-19-53		$
			$
			$
	O'head		$
			$ 112.76

86.66

St. / ~~Pl.~~ Ave. No. 112

Lawrence

Name of Owner

Donnelly

Labor and Mat'l. Report May 19 1953

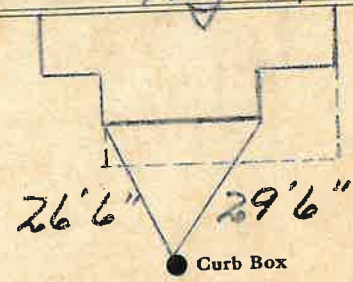

12" changed over 4½"

Main 9-14-55 Elev. of Main at tap 6

Gate at ● ● Gate at

● Curb Box

Old service disconnected 5-21-53 by Gifford

LSM-SC 5 15-48