Labor and Materials

1	~~Lead~~ Connection	$
1	Curb Cock 3/4	$
1	Service Box Old returned { Short 3½ x 4½ / ~~Long 4½~~ x 5½ / ~~Buffalo~~ }	$
7	Ft. 3/4 in. G. I. Pipe at Cup	$
	Nipples ..... in. at	$
	Bushings ..... to ..... in. at	$
	Red'g Coup .... to .... in. at	$
	Inc'g Coup .... to .... in. at	$
	Union .... in. at	$
	Meter .... in. at	$
	Cu. Yds. Br. Stone at	$
	Cu. Yds. Sand at	$
	Bags Cement at	$
	Paving Brick { Mack / Red / Asphalt } at	$
4	Hrs. Foreman at	$
19	Hrs. Common Labor at	$
4	Hrs. Mason at	$
5½	Hrs. 50 ¢ L. at	$
	Hrs. at	$
Inv	Builders' Use of Water	$
	at	$
	Truck 100 at	$
	Cram processor 1 hr at	$
	at	$
	Total	$ 25.66

20 HB LAWRENCE ST.

Labor and Material Report June 20 1925

3/4 Tap at 12 Lawrence St

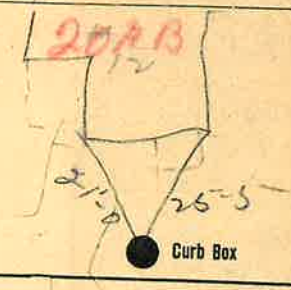

12 Main

Elev. of Main at tap 5'

Gate at ●

● Gate at

● Curb Box

Nasen