Labor and Materials

3/4 ~~Lead~~ Connection 1 ..... $.....

1 Curb Cock 3/4 ..... $.....

1 Service Box ~~Old returned~~ { Short 3½ x 4½ / ~~Long 4½ x 5½~~ / ~~Buffalo~~ } $.....

8 Ft. 3/4 in. G. I. Pipe at Cop ..... $.....

Nipples ..... in. at ..... $.....

Bushings ..... to ..... in. at ..... $.....

Red'g Coup .... to .... in. at ..... $.....

Inc'g Coup .... to .... in. at ..... $.....

Union .... in. at ..... $.....

Meter .... in. at ..... $.....

Cu. Yds. Br. Stone at ..... $.....

Cu. Yds. Sand at ..... $.....

Bags Cement at ..... $.....

Paving Brick { Mack / Red / Asphalt } at ..... $.....

2 Hrs. Foreman at ..... $.....

14 Hrs. Common Labor at ..... $.....

4 Hrs. Mason at ..... $.....

9½ Hrs. 50¢ L. ..... at ..... $.....

Hrs. ..... at ..... $.....

9 Builders' Use of Water ..... $.....

..... at ..... $.....

Truck 1 ..... at ..... $.....

..... at ..... $.....

..... at ..... $.....

Total $.....

---

22 LAWRENCE ST

Labor and Material Report 1925

3/4 Tap at 14 Lawrence St

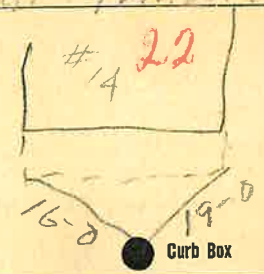

12 Main

Elev. of Main at tap 5'

Gate at ●

● Gate at

● Curb Box

Clark